


Prepared by:
BWS Architects
261 N. Court Ave.
Tucson, Arizona 85701

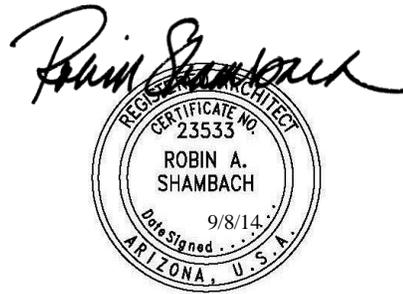

EXPIRES 06/30/2016

Project:
Pinal County Regional Health Clinic - Eloy
Pinal County, Arizona
PN 53330041

ADDENDUM NO. 2
September 9, 2014

All requirements contained in the Contract Documents dated July 16, 2014 shall apply to this Addendum, and the general character of the Work called for in this Addendum shall be the same as originally set forth in the applicable portions of the Contract Documents for similar Work, unless otherwise specified under this Addendum, and all incidental Work necessitated by this Addendum as required to complete the Work shall be included in the bids, even though not particularly mentioned in this Addendum.

This Addendum is hereby made a part of the Contract Documents.
Acknowledge receipt of this Addendum in the space provided on the proposal form. Failure to do so may subject bidder to disqualification.

DRAWINGS RE-ISSUED WITH THIS ADDENDUM: The following drawings have been revised and reissued with this addendum: **Revised Detail 7/A3.1.**

GENERAL ITEMS:

1. Section 9 of Bid Document entitled General Provisions within Volume 1, gives the insurance requirements. In section 9.15 it states that all subcontractors will be required to carry the same coverage that the GC's are required to carry, is this correct?

Yes, the subcontractors shall maintain the same coverage.

2. Liquid Damages- Section 27 of the Bid Document entitled Special Provisions and Specifications, it stated the liquid damages would be in the amount of \$2000.00 per day; yet the pre-bid outline handed out at the pre-bid meeting states it would be \$500.00 per day. Could you please clarify which is the correct amount for liquid damages?

The liquidated damages amount is \$500.00 per day.

3. The bid document makes several different references to what is actually required to be submitted with the bid. Could you please clarify which documents are required to be submitted with the bid document?
Each bidder shall submit the bound properly completed "Volume - 1" in its entirety.
4. Can heat pump #2 be relocated to reduce lineal footage of duct work?
No. Existing heat pump 2 to remain in place.
5. Round duct work calls for duct wrap- Can square duct work be wrapped in lieu of liner?
It is acceptable to wrap the square / rectangular duct, however, we do require the duct to be lined through the first elbow.
6. Has the interior paint been tested for lead?
Yes. Tests for lead paint on walls and ceilings came back negative.
7. Is all drywall being removed at the ceiling?
Yes. Refer to Demolition Plan General Note number 4.
8. What will be the drywall texture?
Drywall texture shall be light orange peel.
9. What light fixture needs to be quoted for the hard lid? (the fixture that is specified will not fit)
Drywall lids have been lowered 8" to accommodate specified light fixtures – Ref. attached A3.1 revisions.
10. Can the new SES be replaced to the North?
No. Locate SES as shown, per APS requirements.
11. Does the asphalt between the street and sidewalk, on the 5th Street side of building, get replaced?
Yes. Remove asphalt between existing concrete curb and sidewalk; prep and replace with DG, as shown on L1.0.
12. Is the intent to replace all the plumbing lines? If so what are they being replaced with?
It is not the intent to replace ALL of the piping, however, most of the piping is new. Refer to book specifications section 23 07 00 for piping materials.


END OF ADDENDUM NO. 2

ADDENDUM NO. 2-3

REFLECTED CEILING PLAN GENERAL NOTES

6. ALL GWB CEILINGS TO BE 8'-4" AFF; ALL ACOUSTICAL PANEL CEILINGS TO BE 8'-6" AFF, UNLESS NOTED OTHERWISE.

8 GA. HANGER WIRES 4'-0" O.C. @
EA. CARRYING CHANNEL

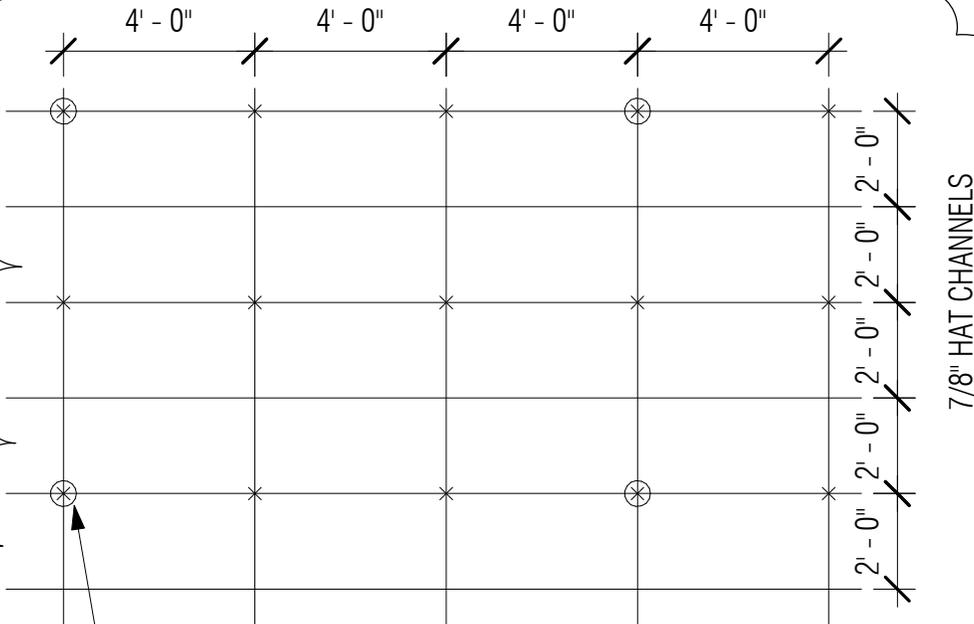

4-WAY 45 DEGREE DIAGONAL 12 GA. WIRE BRACING @ 8'-0" X 2'-0" CROSS FURRING SHALL BE SPLICED BY LAPPING AND INTERLOCKING THE PEICES BY 8" MIN. AND TYING NEAT EACH END W/ DOUBLE LOOPS OF #16 WIRE

**DIAGRAMATIC CEILING PLAN
- GYPSUM BOARD CEILINGS**

7

1/4" = 1'-0"

bws ARCHITECTS

BURNS WALD-HOPKINS SHAMBACH ARCHITECTS

261 North Court Avenue
Tucson, Arizona 85701
520.795.2705 Fax 520.795.6171
www.bwsarchs.com

PINAL COUNTY
ELOY HEALTH CLINIC

JOB NO: 1404.000

DATE: 9 SEPT. 2014

REVISED GENERAL NOTE #6
REVISED DETAIL 7/A3.1 -
CEILING FRAMING

SHEET A3.1 REVISIONS